



These documents are instruments of service and are the copyright property of Tacoma Engineers. They may not be reproduced, altered or misused without the expressed written consent of Tacoma Engineers Inc.

No. / Date / Revision / Issued for:  
 1 / 2020-01-30 / AS-BUILT SCHEMATIC DEMO

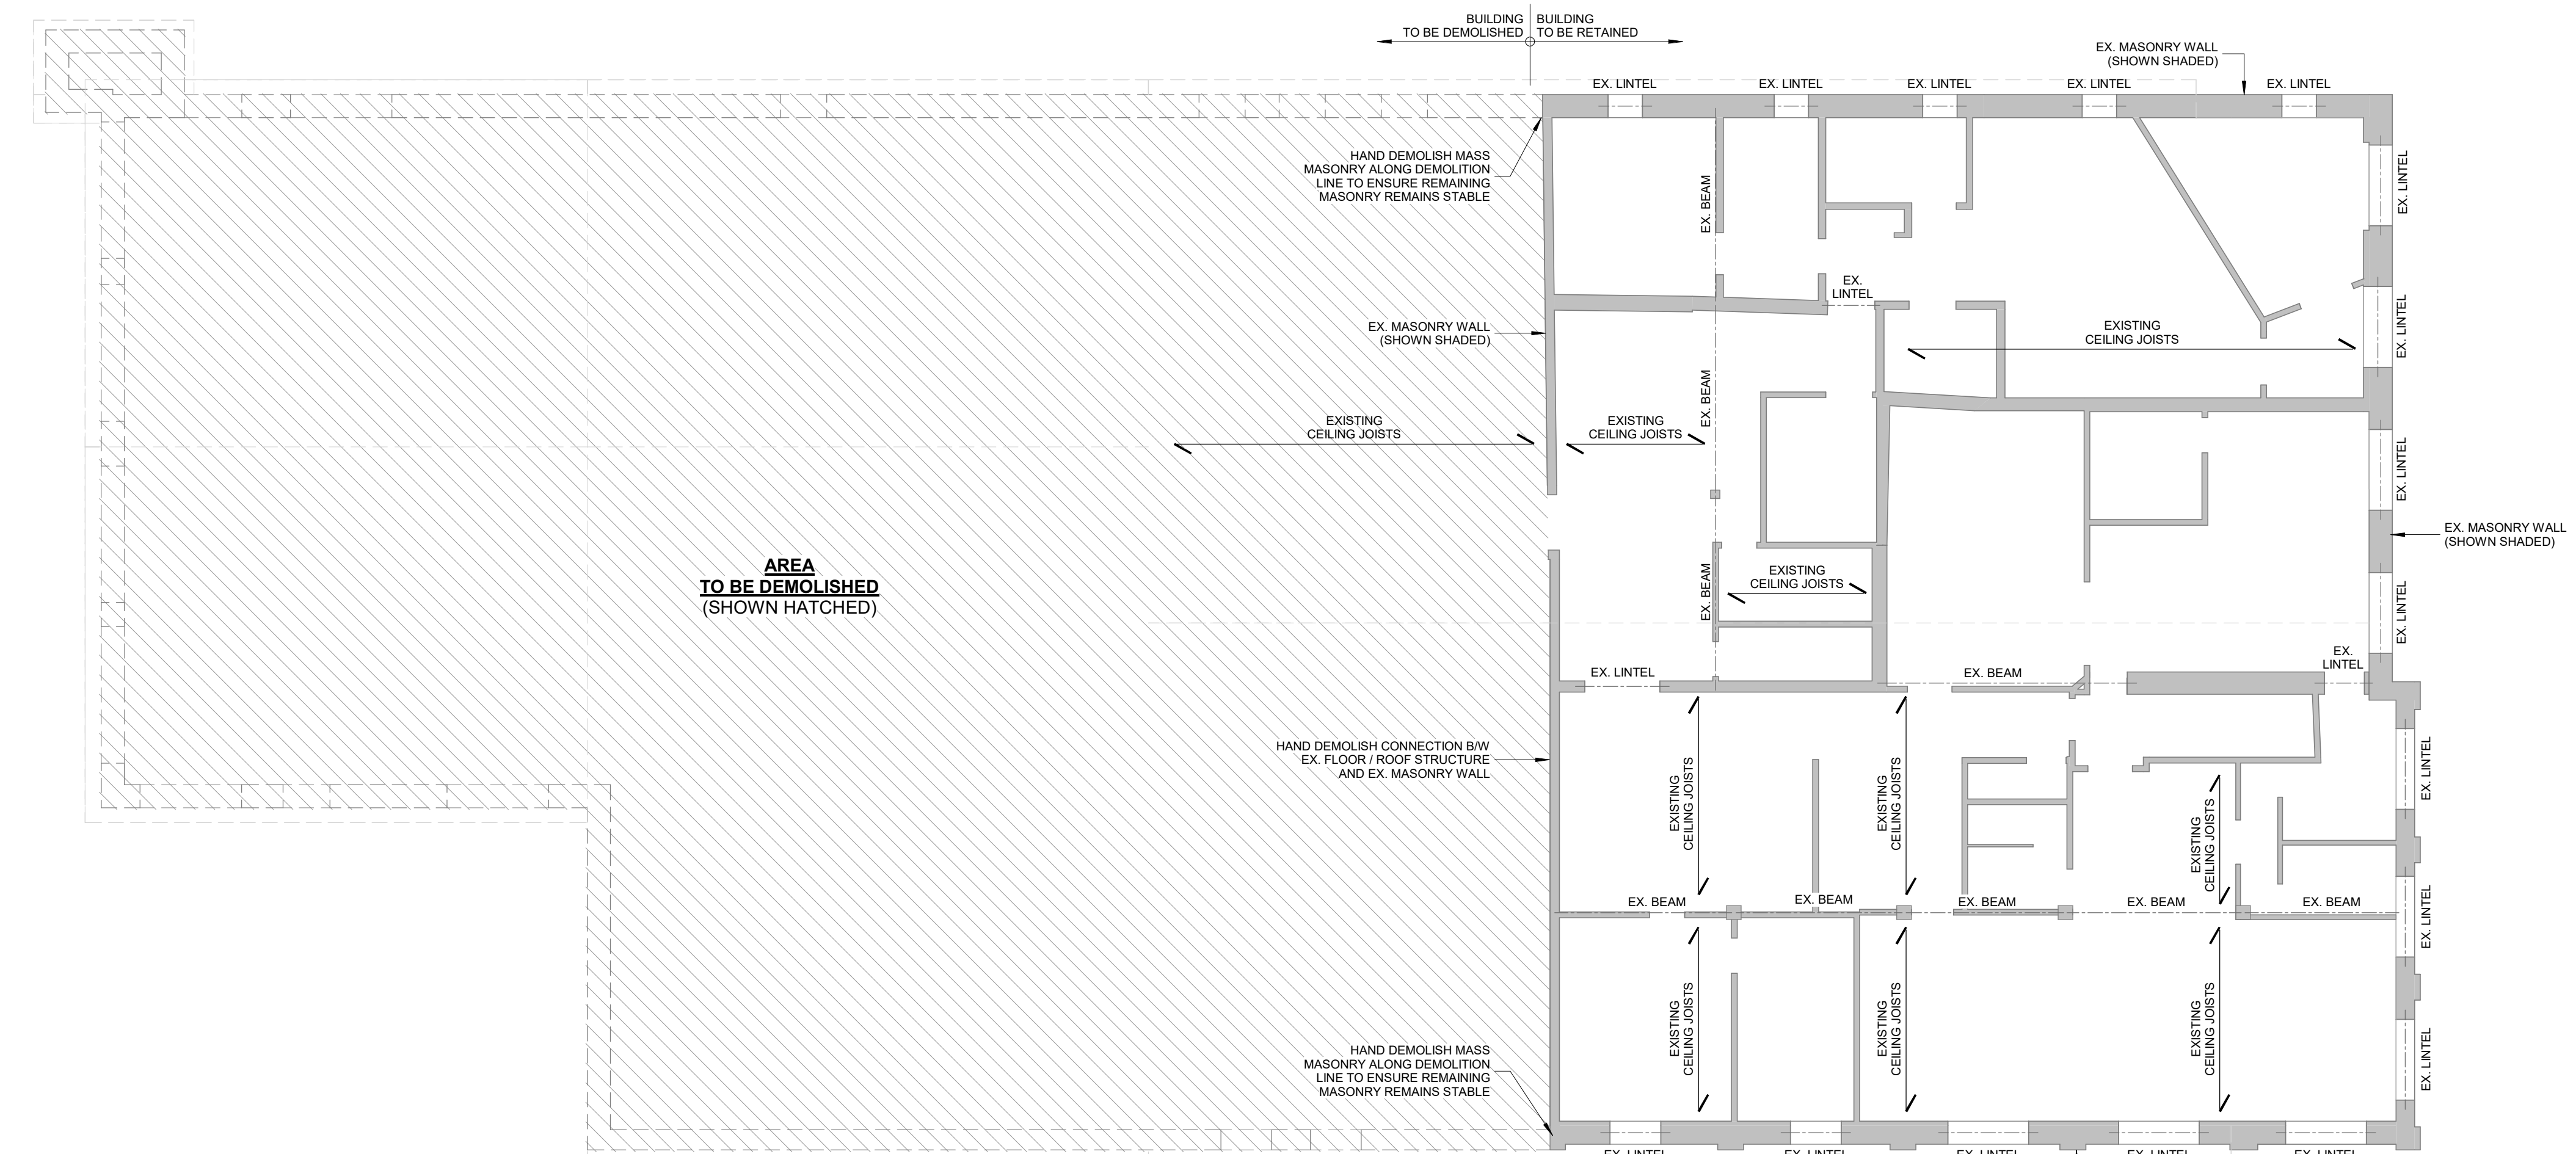

**PARTIAL SECOND FLOOR / ROOF DEMO FRAMING PLAN - SCHEMATIC**  
 SCALE: 1:100

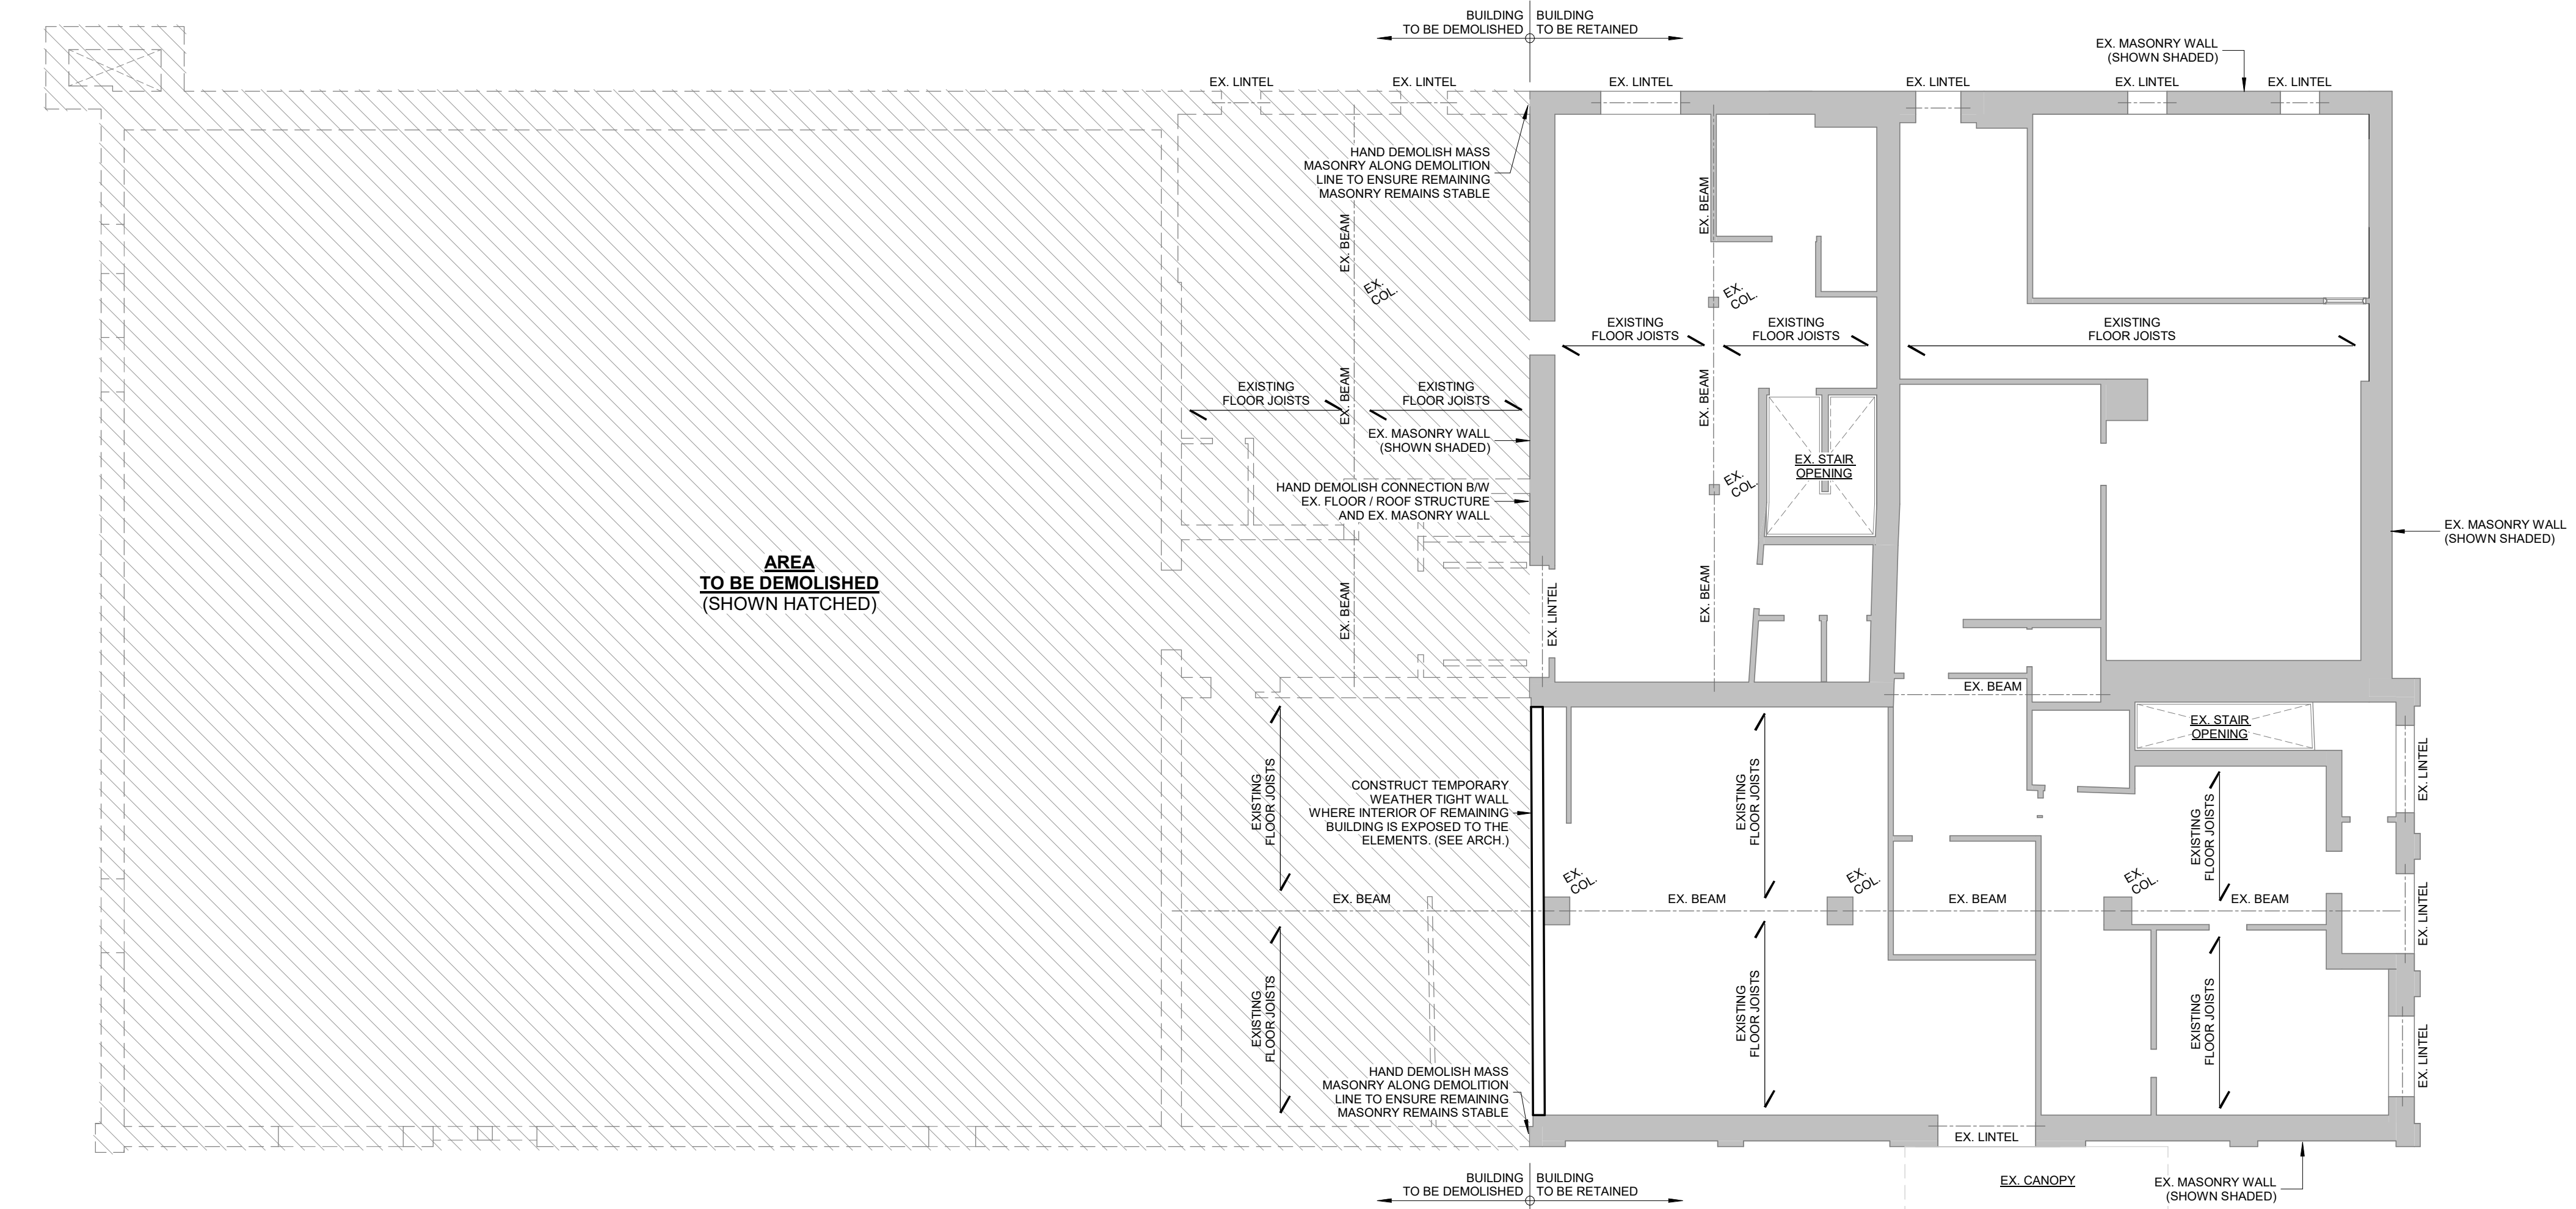

**PARTIAL FIRST FLOOR DEMO FRAMING PLAN - SCHEMATIC**  
 SCALE: 1:100

REFER TO ARCHITECTURAL PLANS FOR ALL DIMENSIONS

**LEGEND:**  
 ——— DENOTES SPAN OF STRUCTURAL MEMBERS, AS NOTED

**TACOMA**  
 ENGINEERS  
 176 Speedvale Avenue West  
 Guelph, Ontario N1H 1C3  
 Tel: 519.763.2000  
 www.tacomaeengineers.com

**McCallumSather**  
 Westinghouse HQ, 2nd Floor  
 286 Sanford Ave. N  
 Hamilton, ON L8L 6A1  
 905.526.6700  
 www.mccallumsather.com

**63 COURTLAND AVE.**  
 63 COURTLAND AVE. E, KITCHENER, ON.

**PARTIAL DEMO/  
 FRAMING PLAN  
 SCHEMATICS**

Project No. / Drawn By:  
 TE-XXXXX-25 / S.W.

**S2.0**